Description:	GF Gallery Bay 5 Track Lights Far
Cable ID:	GF006-LTS-021
Cable Type:	SC Flex
Cable CSA:	1.5mm
Cable Length:	35m
Light Fitting:	Eagle
Light Load:	36W
Light Amount:	3
Total Load:	108W
Dist Zone:	DZ0
Lts Mod/Chan:	Dm1/ 1,2,3
DB/W/L/Cct:	DB1/W1/L3/03

Description:	GF Gallery Bay 5 Ceiling Lights
Cable ID:	GF006-LTS-005
Cable Type:	T&E
Cable CSA:	1.0mm
Cable Length:	15m
Light Fitting:	Ansell Fresko 9W
Light Load:	9W
Light Amount:	4
Total Load:	36W
Dist Zone:	DZ0
Lts Mod/Chan:	Dm4/7
DB/W/L/Cct:	DB1/W2/L3/06

Description:	GF Gallery Bay 4 Track Lights Far
Cable ID:	GF006-LTS-019
Cable Type:	SC Flex
Cable CSA:	1.5mm
Cable Length:	30m
Light Fitting:	Eagle
Light Load:	36W
Light Amount:	3
Total Load:	108W
Dist Zone:	DZ0
Lts Mod/Chan:	Dm3/ 4,5,6
DB/W/L/Cct:	DB1/W8/L3/24

Description:	GF Gallery Bay 4 Ceiling Lights
Cable ID:	GF006-LTS-004
Cable Type:	T&E
Cable CSA:	1.0mm
Cable Length:	15m
Light Fitting:	Ansell Fresko 9W
Light Load:	9W
Light Amount:	4
Total Load:	36W
Dist Zone:	DZ0
Lts Mod/Chan:	Dm4/7
DB/W/L/Cct:	DB1/W2/L3/06

Description:	GF Gallery Bay 3 Track Lights Far
Cable ID:	GF006-LTS-017
Cable Type:	SC Flex
Cable CSA:	1.5mm
Cable Length:	25m
Light Fitting:	Eagle
Light Load:	36W
Light Amount:	3
Total Load:	108W
Dist Zone:	DZ0
Lts Mod/Chan:	Dm3 / 1,2,3
DB/W/L/Cct:	DB1/W8/L3/24

Description:	GF Gallery Bay 3 Ceiling Lights
Cable ID:	GF006-LTS-003
Cable Type:	T&E
Cable CSA:	1.0mm
Cable Length:	15m
Light Fitting:	Ansell Fresko 9W
Light Load:	9W
Light Amount:	4
Total Load:	36W
Dist Zone:	DZ0
Lts Mod/Chan:	Dm4/7
DB/W/L/Cct:	DB1/W2/L3/06

Description:	GF Gallery Bay 3 PIR Sensor
Cable ID:	GF006-LTS-011
Cable Type:	3CE
Cable CSA:	1.0mm
Cable Length:	30m
Light Fitting:	PIR
Light Load:	20W
Light Amount:	1
Total Load:	20W
Dist Zone:	DZ0
Lts Mod/Chan:	Currently Unused
DB/W/L/Cct:	Currently Unused

Description:	GF Gallery Bay 2 Track Lights Far
Cable ID:	GF006-LTS-015
Cable Type:	SC Flex
Cable CSA:	1.5mm
Cable Length:	20m
Light Fitting:	Eagle
Light Load:	36W
Light Amount:	3
Total Load:	108W
Dist Zone:	DZ0
Lts Mod/Chan:	Dm2/ 4,5,6
DB/W/L/Cct:	DB1/W7/L3/21

Description:	GF Gallery Bay 2 Ceiling Lights
Cable ID:	GF006-LTS-002
Cable Type:	T&E
Cable CSA:	1.0mm
Cable Length:	15m
Light Fitting:	Ansell Fresko 9W
Light Load:	9W
Light Amount:	4
Total Load:	36W
Dist Zone:	DZ0
Lts Mod/Chan:	Dm4/7
DB/W/L/Cct:	DB1/W2/L3/06

Description:	GF Gallery Bay 1 Track Lights Far
Cable ID:	GF006-LTS-013
Cable Type:	SC Flex
Cable CSA:	1.5mm
Cable Length:	15m
Light Fitting:	Eagle
Light Load:	36W
Light Amount:	3
Total Load:	108W
Dist Zone:	DZ0
Lts Mod/Chan:	Dm2/ 1,2,3
DB/W/L/Cct:	DB1/W7/L3/21

Description:	GF Bay Oak Beam Lights Far
Cable ID:	GF006-LTS-010
Cable Type:	T&E
Cable CSA:	1.0mm
Cable Length:	35m
Light Fitting:	?
Light Load:	60W
Light Amount:	6
Total Load:	360W
Dist Zone:	DZ0
Lts Mod/Chan:	Dm3/7
DB/W/L/Cct:	DB1/W8/L3/24

Description:	GF Gallery Bay 1 Ceiling Lights
Cable ID:	GF006-LTS-001
Cable Type:	T&E
Cable CSA:	1.0mm
Cable Length:	15m
Light Fitting:	Ansell Fresko 9W
Light Load:	9W
Light Amount:	4
Total Load:	36W
Dist Zone:	DZ0
Lts Mod/Chan:	Dm 4/7
DB/W/L/Cct:	DB1/W2/L3/06

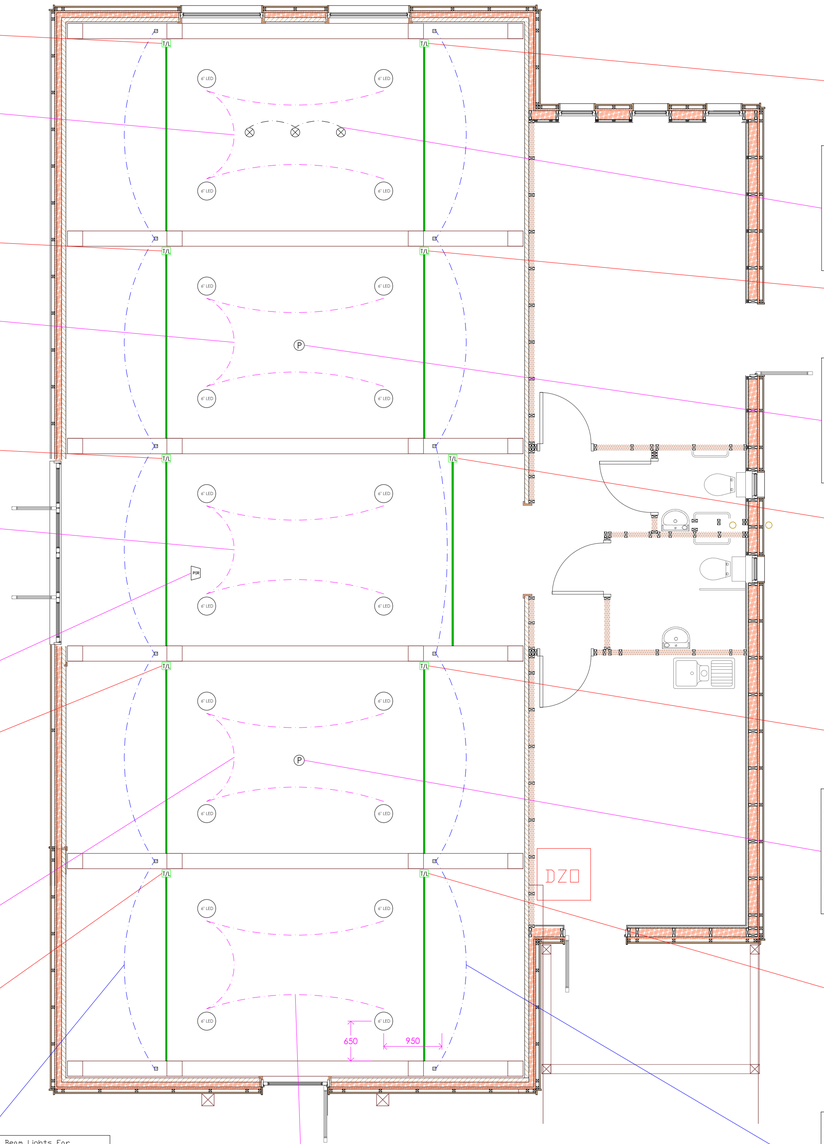

Description:	GF Gallery Bay 5 Desk Lights
Cable ID:	GF006-LTS-006
Cable Type:	T&E
Cable CSA:	1.0mm
Cable Length:	35m
Light Fitting:	Ansell Orbio 7.6W
Light Load:	7.6W
Light Amount:	3
Total Load:	22.8W
Dist Zone:	DZ0
Lts Mod/Chan:	Dm4/8
DB/W/L/Cct:	DB1/W2/L3/06

Description:	GF Gallery Bay 4 Display Table Light
Cable ID:	GF006-LTS-007
Cable Type:	T&E
Cable CSA:	1.0mm
Cable Length:	30m
Light Fitting:	Pendant
Light Load:	60W
Light Amount:	1
Total Load:	60W
Dist Zone:	DZ0
Lts Mod/Chan:	Dm2/7
DB/W/L/Cct:	DB1/W7/L3/21

Description:	GF Gallery Bay 2 Display Table Light
Cable ID:	GF006-LTS-008
Cable Type:	T&E
Cable CSA:	1.0mm
Cable Length:	30m
Light Fitting:	Pendant
Light Load:	60W
Light Amount:	1
Total Load:	60W
Dist Zone:	DZ0
Lts Mod/Chan:	Dm2/8
DB/W/L/Cct:	DB1/W7/L3/21

Description:	GF Bay Oak Beam Lts Near
Cable ID:	GF006-LTS-009
Cable Type:	T&E
Cable CSA:	1.0mm
Cable Length:	35m
Light Fitting:	?
Light Load:	60W
Light Amount:	6
Total Load:	360W
Dist Zone:	DZ0
Lts Mod/Chan:	Dm3/7
DB/W/L/Cct:	DB1/W8/L3/24

Description:	GF Gallery Bay 5 Track Lights Near
Cable ID:	GF006-LTS-020
Cable Type:	SC Flex
Cable CSA:	1.5mm
Cable Length:	35m
Light Fitting:	Eagle
Light Load:	36W
Light Amount:	3
Total Load:	108W
Dist Zone:	DZ0
Lts Mod/Chan:	Dm1/ 1,2,3
DB/W/L/Cct:	DB1/W1/L3/03

Description:	GF Gallery Bay 4 Track Lights Near
Cable ID:	GF006-LTS-018
Cable Type:	SC Flex
Cable CSA:	1.5mm
Cable Length:	30m
Light Fitting:	Eagle
Light Load:	36W
Light Amount:	3
Total Load:	108W
Dist Zone:	DZ0
Lts Mod/Chan:	Dm3/ 4,5,6
DB/W/L/Cct:	DB1/W8/L3/24

Description:	GF Gallery Bay 3 Track Lights Near
Cable ID:	GF006-LTS-016
Cable Type:	SC Flex
Cable CSA:	1.5mm
Cable Length:	25m
Light Fitting:	Eagle
Light Load:	36W
Light Amount:	3
Total Load:	108W
Dist Zone:	DZ0
Lts Mod/Chan:	Dm3 / 1,2,3
DB/W/L/Cct:	DB1/W8/L3/24

Description:	GF Gallery Bay 2 Track Lights Near
Cable ID:	GF006-LTS-014
Cable Type:	SC Flex
Cable CSA:	1.5mm
Cable Length:	20m
Light Fitting:	Eagle
Light Load:	36W
Light Amount:	3
Total Load:	108W
Dist Zone:	DZ0
Lts Mod/Chan:	Dm2/ 4,5,6
DB/W/L/Cct:	DB1/W7/L3/21

Description:	GF Gallery Bay 1 Track Lights Near
Cable ID:	GF006-LTS-012
Cable Type:	SC Flex
Cable CSA:	1.5mm
Cable Length:	15m
Light Fitting:	Eagle
Light Load:	36W
Light Amount:	3
Total Load:	108W
Dist Zone:	DZ0
Lts Mod/Chan:	Dm2/ 1,2,3
DB/W/L/Cct:	DB1/W7/L3/21

Client Notes.

/

Key - Lighting

- 6" LED — Fresca 9W LED Ceiling Light
- Recessed Downlight
- P — Pendant
- LCP — Lighting Connection Point
- Floor Spot - Angled
- IP67 Floor Mounted Up Light
- Surface Spot Light - Angled
- Wall Light
- T/L — Track Light
- EM — Emergency Light
- F — Extract Fan

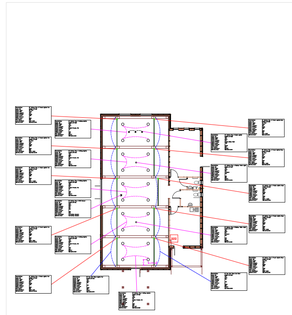

Client/ Works Name:	
Client/ Works Address:	
Mobile #:	/
Email:	

AS BUILT PLANS

ILLUSTRATED LAYOUT OF THIS PROPERTY HAS BEEN TAKEN FROM ARCHITECT PLANS. ORIGINAL PLANS ARE COPYRIGHT OF THE ARCHITECT.

DRAWING CONTENT

Drawing # :	Drawing Date :
Drawing # :	Drawing Date :
Drawing # :	Drawing Date :
Drawing # :	Drawing Date :
Drawing # : Ground Floor Track Lights	Drawing Date : 28/02/2018
Drawing # : Ground Floor Ceiling Lights	Drawing Date : 28/02/2018
Drawing # :	Drawing Date :
Drawing # : Ground Floor Oak Beam Lights	Drawing Date : 28/02/2018
Drawing # :	Drawing Date :

Size :	Scale :	Designer :
A1	1/50 @ A1	N/A

PARTNER KNX RTI

Intelligent Installations

CEDIA MEMBER Control4

58 Trelawney Av, St. Ives, Cornwall, TR26 1AS | E: Info@intelligentinstallations.co.uk | T: 01736-797417 | M: 07816067921 | www.intelligentinstallations.co.uk | VAT #: 255 8567 63 | Company Reg: 10478833

MAPIT Accredited Pro

CEDIA MEMBER